

NOTE: THE BASE DIAMETER IS APPROXIMATELY 62" AND THE TOP DIAMETER IS APPROXIMATELY 25".

MONOPINE ELEVATION
SCALE: 1/16"=1'-0"

E1
AB-2

SUBMITTALS

DATE	DESCRIPTION	REV.
01-11-11	AS-BUILT	
05-27-14	AS-BUILT	
12-21-16	AS-BUILT	



6600 Rockledge Drive, Suite 550
BETHESDA, MD 20817
PHONE: (202)408-0960
FAX: (202)408-0961

**HOLMES RUN
ACRES REC. ASSN.
AS-BUILT**

3457 GALLOWES RD.
FALLS CHURCH, VA


1094.018

SHEET 2 OF 2

AB-2

CWS

2800 Shirlington Road, Suite 802
Arlington, Virginia 22206
Main Number: 703-845-1971
Fax: 703-845-1953

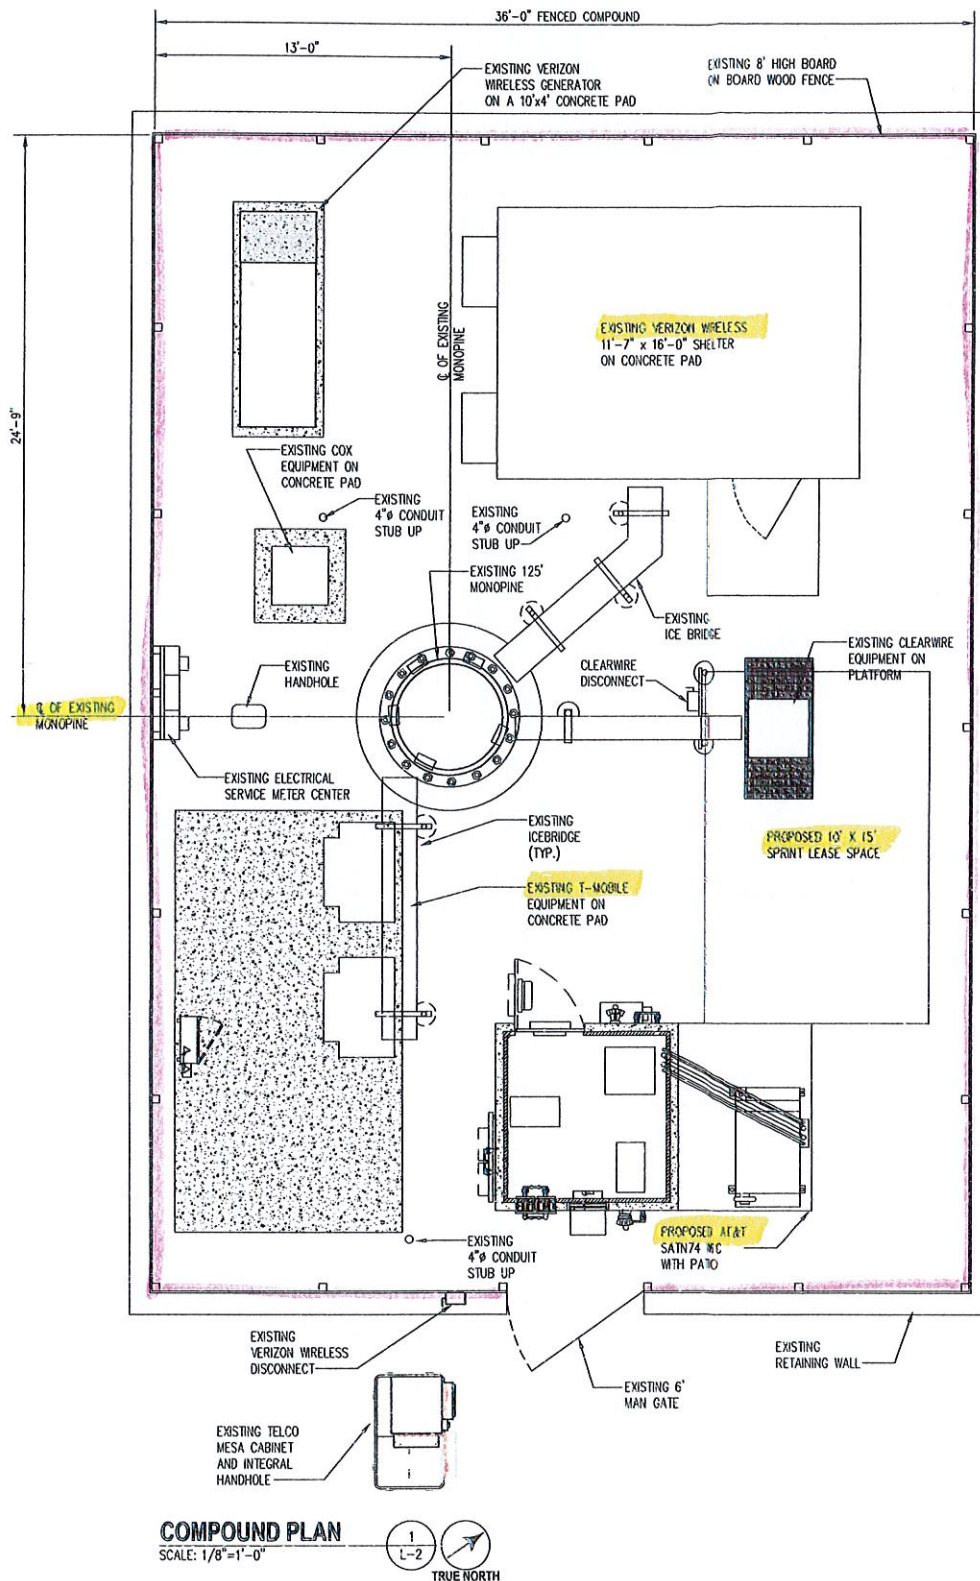

SUBMITTALS		
DATE	DESCRIPTION	REV.
XX-XX-XX	LEASE EXHIBIT REVIEW	



6600 Rockledge Drive, Suite 550
BETHESDA, MD 20817
PHONE: (202)408-0960
FAX: (202)408-0961

HOLMES RUN ACRES REC. ASSN.

3457 GALLOWS RD.
FALLS CHURCH, VA

1094.018

SHEET 2 OF 2

L-2

CWS

2800 Shirlington Road, Suite 802
Arlington, Virginia 22206
Main Number: 703-845-1971
Fax: 703-845-1953